

# MARION COUNTY SURVEYOR'S OFFICE



## SECTION CORNER RECORD

DEBRA S. JENKINS  
MARION COUNTY SURVEYOR

SEC. 14 TWN. 14<sub>N</sub> RNG. 2<sub>E</sub>

BRYAN F. CATLIN, PLS  
TECHNICAL SUPERVISOR

Date: 8-3-09  
Party Chief: Wilcoxen / Greene  
Crew: Finney  
Type of Marker: Harrison  
Method of Establishment: County: 5-20-1999  
IN S.P.C. E Zone, NAD 83  
Name: 14021402  
N: 490 189.545 0(m)  
E: 47 480.644 0(m)

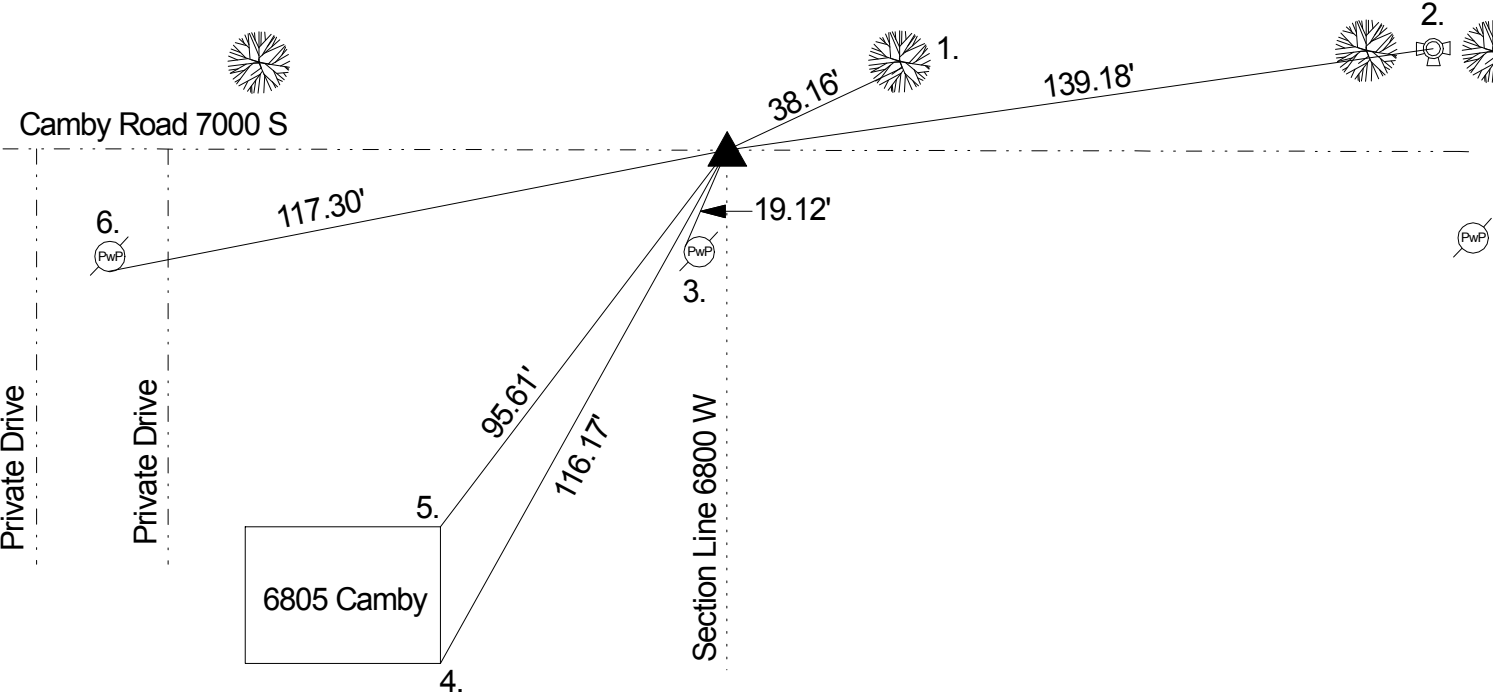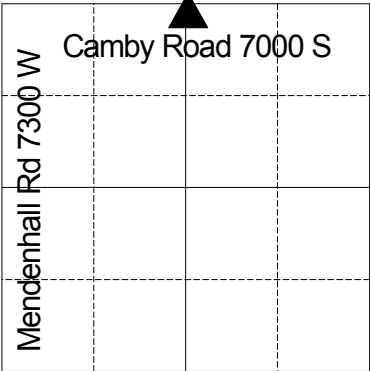

Corner originally set as a post in 1820 by Wm.B. Laughlin with the following witnesses: 14" beech bearing N 68 E 5 links and a 12" beech bearing S 45 W 30 links (Marion County Atlas p. 1). A survey by D.B. Hasbrook on April 23, 1850 indicates no stone or witnesses (Decatur Legal Book p. 16). Corner referenced by Wilcoxen on 4/27/1978 and called a found stone as per deed records. Corner referenced by Greene on 7/9/85 and called a stone 9" down. Corner excavated by Greene on 6/30/87 and a stone was found 12" down. A #205 cast iron Harrison monument was set on top of the stone. Corner referenced by Kiste on 9/19/94 and called a Harrison monument . Corner referenced by Kiste on 5/20/1999 and called a Harrison monument. 8/28/2004 Wilcoxen retied. Corner referenced by Wilcoxen on 6/8/07 and a 3" riser was installed on Harrison monument. 8/3/09 Wilcoxen retied.

REF.	DISTANCE	DESCRIPTION
1.	38.16'	Boat spike S 15" Ash 12" up
2.	139.18'	Top nut of fire hydrant
3.	19.12'	Road nail W PwP #65-742 12" up
4.	116.17'	SE corner of foundation 6805 Camby Road
5.	95.61'	NE corner of foundation 6805 Camby Road
6.	117.30'	PK nail S PwP #66-742 8" up